

Important: Read the instructions on pages 1 - 7.

SECTION A - PROPERTY OWNER INFORMATION.

For Insurance Company Use:

Policy Number

Company NAIC Number

PROPERTY OWNER'S NAME

MAILING STREET ADDRESS (Including Apt., Unit, Suite, and/or Bldg. No.) OR P.O. ROUTE AND BOX NO.

ZIP CODE

8137 WENDY LANE

STATE

TEXAS

BENBROOK

PROPERTY DESCRIPTION (Lot and Block Numbers, Tax Parcel Number, Legal Description, etc.)

LOT 10 BLOCK 7 THE MEADOWS

PLANNING USE (e.g. Residential, Non-residential, Addition, Accessory, etc. Use Comments section if necessary.)

RESIDENTIAL

TITLE/ALONGITUDE (OPTIONAL)

HORIZONTAL DATUM:

SOURCE: GPS (Type: _____)

NAD 1983 or NAD 1983

NAD 1927 NAD 1983

USGS Quad Map Other: _____

SECTION B - FLOOD INSURANCE RATE MAP (FIRM) INFORMATION

FIRM COMMUNITY NAME & COMMUNITY NUMBER

B2. COUNTY NAME

B3. STATE

BENBROOK 480586 0380 H

TARRANT

TEXAS

B4. MAP AND PANEL NUMBER

B5. SUFFIX

B6. FIRM INDEX DATE

B7. FIRM PANEL EFFECTIVE/REVISED DATE

B8. FLOOD ZONE(S)

B9. BASE FLOOD ELEVATION(S) (Zone AO, use depth of flooding)

8439C0380

H

1-6-93

B-2-95

AE

639.0

1. Indicate the source of the Base Flood Elevation (BFE) data or base flood depth entered in B9.

FIS Profile

FIRM

Community Determined

Other (Describe): _____

1. Indicate the elevation datum used for the BFE in B9: NGVD 1929 NAVD 1988 Other (Describe): FIRM

2. Is the building located in a Coastal Barrier Resources System (CBRS) area or Otherwise Protected Area (OPA)? Yes No

Designation Date: _____

SECTION C - BUILDING ELEVATION INFORMATION (SURVEY REQUIRED)

Building elevations are based on: Construction Drawings* Building Under Construction* Finished Construction

*A new Elevation Certificate will be required when construction of the building is complete.

Building Diagram Number 1 (Select the building diagram most similar to the building for which this certificate is being completed - see pages 6 and 7. If no diagram accurately represents the building, provide a sketch or photograph.)

Elevations - Zones A1-A30, AE, AH, A (with BFE), VE, V1-V30, V (with BFE), AR, ARIA, ARIA/E, ARIA/A1-A30, ARIA/H, ARIA/O


Complete Items C3a-i below according to the building diagram specified in Item C2. State the datum used. If the datum is different from the datum used for the BFE in Section B, convert the datum to that used for the BFE. Show field measurements and datum conversion calculation. Use the space provided or the Comments area of Section D or Section G, as appropriate, to document the datum conversion

Datum _____ Conversion/Comments _____

Elevation reference mark used RM 352 Does the elevation reference mark used appear on the FIRM? Yes No

- a) Top of bottom floor (including basement or enclosure) _____ ft.(m)
- b) Top of next higher floor _____ ft.(m)
- c) Bottom of lowest horizontal structural member (V zones only) _____ ft.(m)
- d) Attached garage (top of slab) _____ ft.(m)
- e) Lowest elevation of machinery and/or equipment servicing the building _____ ft.(m)
- f) Lowest adjacent grade (LAG) 640.00 ft.(m)
- g) Highest adjacent grade (HAG) _____ ft.(m)
- h) No. of permanent openings (flood vents) within 1 ft. above adjacent grade _____
- i) Total area of all permanent openings (flood vents) in C3h _____ sq. in. (sq. cm)

License Number, Embossed Seal, Signature, and Date

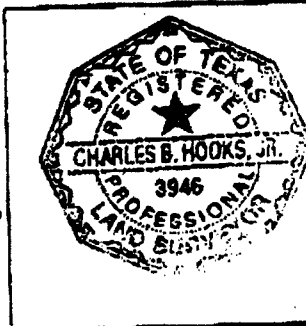

SECTION D - SURVEYOR, ENGINEER, OR ARCHITECT CERTIFICATION

This certification is to be signed and sealed by a land surveyor, engineer, or architect authorized by law to certify elevation information. I certify that the information in Sections A, B, and C on this certificate represents my best efforts to interpret the data available. I understand that any false statement may be punishable by fine or imprisonment under 18 U.S. Code, Section 1001.

CERTIFIER'S NAME CHARLES B. HOOKS, JR.

LICENSE NUMBER 3946

TITLE RPLS

COMPANY NAME LOYD BRANSON SURVEYORS, INC.

ADDRESS 1028 NORTH SYLVANIA AVE.

CITY FORT WORTH

STATE TEXAS ZIP CODE 76111

SIGNATURE *Charles B. Hooks, Jr.*

DATE 9-29-00

TELEPHONE 817-8343477

STATE

ZIP CODE

Company NAIC Number

SECTION D - SURVEYOR, ENGINEER, OR ARCHITECT CERTIFICATION (CONTINUED)

by both sides of this Elevation Certificate for (1) community official, (2) insurance agent/company, and (3) building owner.

REMARKS

MIN. FIN. FLR. PER: PLAT = 641.3

Check here if attachments

SECTION E - BUILDING ELEVATION INFORMATION (SURVEY NOT REQUIRED) FOR ZONE AO AND ZONE A (WITHOUT BFE)

Zone AO and Zone A (without BFE), complete Items E1 through E4. If the Elevation Certificate is intended for use as supporting information for a LOMA or LOMR-F, Section C must be completed.

Building Diagram Number _____ (Select the building diagram most similar to the building for which this certificate is being completed - see pages 6 and 7. If no diagram accurately represents the building, provide a sketch or photograph.)

The top of the bottom floor (including basement or enclosure) of the building is _____ ft.(m) _____ in.(cm) _____ above or _____ below (check one) the highest adjacent grade.

For Building Diagrams 6-8 with openings (see page 7), the next higher floor or elevated floor (elevation b) of the building is _____ ft.(m) _____ in.(cm) above the highest adjacent grade.

For Zone AO only: If no flood depth number is available, is the top of the bottom floor elevated in accordance with the community's floodplain management ordinance? Yes No Unknown. The local official must certify this information in Section G.

SECTION F - PROPERTY OWNER (OR OWNER'S REPRESENTATIVE) CERTIFICATION

A property owner or owner's authorized representative who completes Sections A, B, and E for Zone A (without a FEMA-issued or community-issued BFE) or Zone AO must sign here.

PROPERTY OWNER'S OR OWNER'S AUTHORIZED REPRESENTATIVE'S NAME

ADDRESS

CITY

STATE

ZIP CODE

SIGNATURE

DATE

TELEPHONE

REMARKS

Check here if attachment

SECTION G - COMMUNITY INFORMATION (OPTIONAL)

A local official who is authorized by law or ordinance to administer the community's floodplain management ordinance can complete Sections A, B, C (or E), and G of this Elevation Certificate. Complete the applicable item(s) and sign below.

The information in Section C was taken from other documentation that has been signed and embossed by a licensed surveyor, engineer, or architect who is authorized by state or local law to certify elevation information. (Indicate the source and date of the elevation data in the Comments area below.)

A community official completed Section E for a building located in Zone A (without a FEMA-issued or community-issued BFE) or Zone AO.

The following information (Items G4-G9) is provided for community floodplain management purposes.

G4. PERMIT NUMBER	G5. DATE PERMIT ISSUED	G6. DATE CERTIFICATE OF COMPLIANCE/OCCUPANCY ISSUED
-------------------	------------------------	---

This permit has been issued for: New Construction Substantial Improvement

Elevation of as-built lowest floor (including basement) of the building is: _____ ft.(m) Datum: _____

BFE or (in Zone AO) depth of flooding at the building site is: _____ ft.(m) Datum: _____

LOCAL OFFICIAL'S NAME

TITLE

COMMUNITY NAME

TELEPHONE

SIGNATURE

DATE


REMARKS

Check here if attachment

SCALE 1"=30'

8137 WENDY LANE

60' R.O.W. - 31' CONCRETE
T/C=849.87
R=350.00
L=48.99

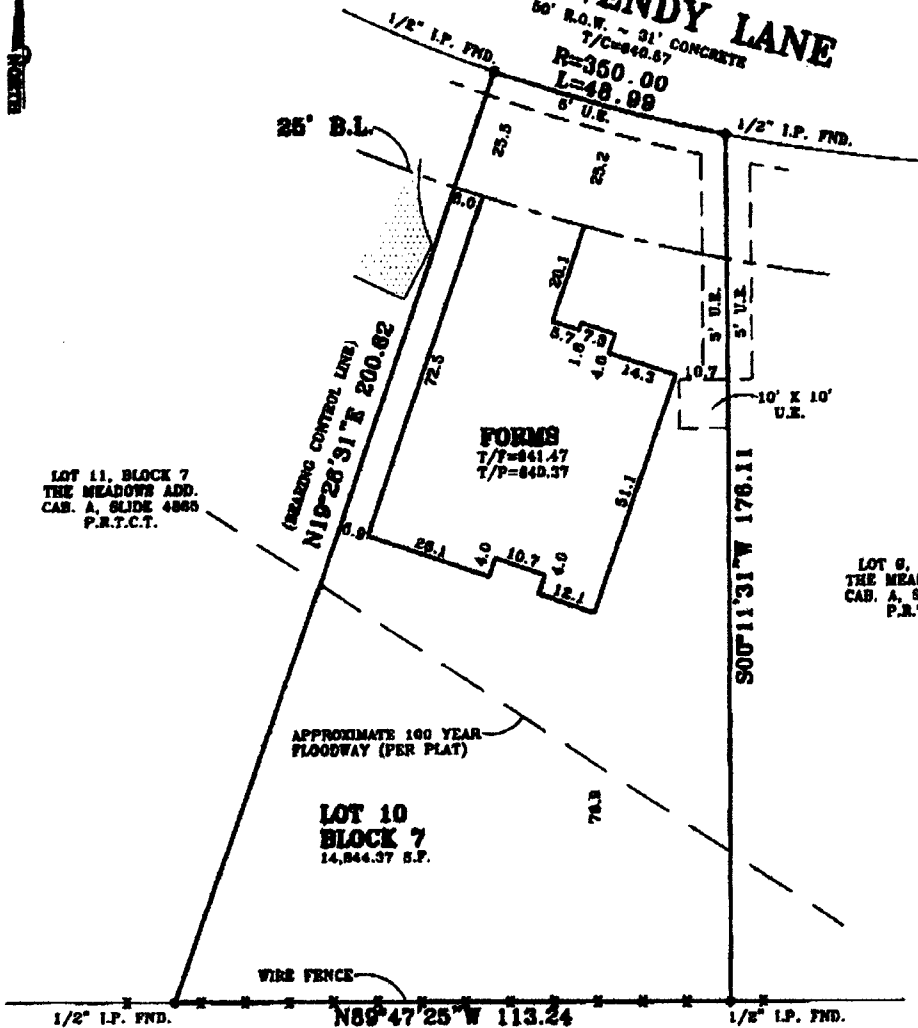

LOT 11, BLOCK 7
THE MEADOWS ADD.
CAB. A, SLIDE 4865
P.R.T.C.T.

LOT 9, BLOCK 7
THE MEADOWS ADD.
CAB. A, SLIDE 4866
P.R.T.C.T.

APPROXIMATE 100 YEAR
FLOODWAY (PER PLAT)

LOT 10
BLOCK 7
14,844.37 S.F.

WIRE FENCE

VOL. 388-132, PG. 60
P.R.T.C.T.

PLAT OF
LOT 10, BLOCK 7, THE MEADOWS ADDITION, AN ADDITION TO THE CITY
OF HENBROOK, TARRANT COUNTY, TEXAS, ACCORDING TO THE PLAT
RECORDED IN CABINET A, SLIDE 4865, PLAT RECORDS, TARRANT
COUNTY, TEXAS

LEGEND

- IRON PIN
- IRON PIPE
- △ BOB D'ARC STAKE
- CONCRETE MON
- X-X- FENCE
- POWER LINE
- T-T- TELEPHONE LINE
- CATV- CABLE TELEVISION
- SHADE AREA DESIGNATES CONCRETE



LOYD BRANSON SURVEYORS INC.
CHARLES B HOOKS JR.
REGISTERED PROFESSIONAL LAND SURVEYOR
1028 NORTH SYLVANIA AVE.
FT. WORTH, TEXAS 76111
834-3477

00-2235

DATE

09-27-00